
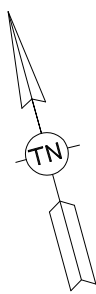


# L4 D33- ORTIA- DOMESTIC DEPARTURES

UPDATE SCHEDULE	
Date	Updated area
02/09/13	Revising as-built room PM

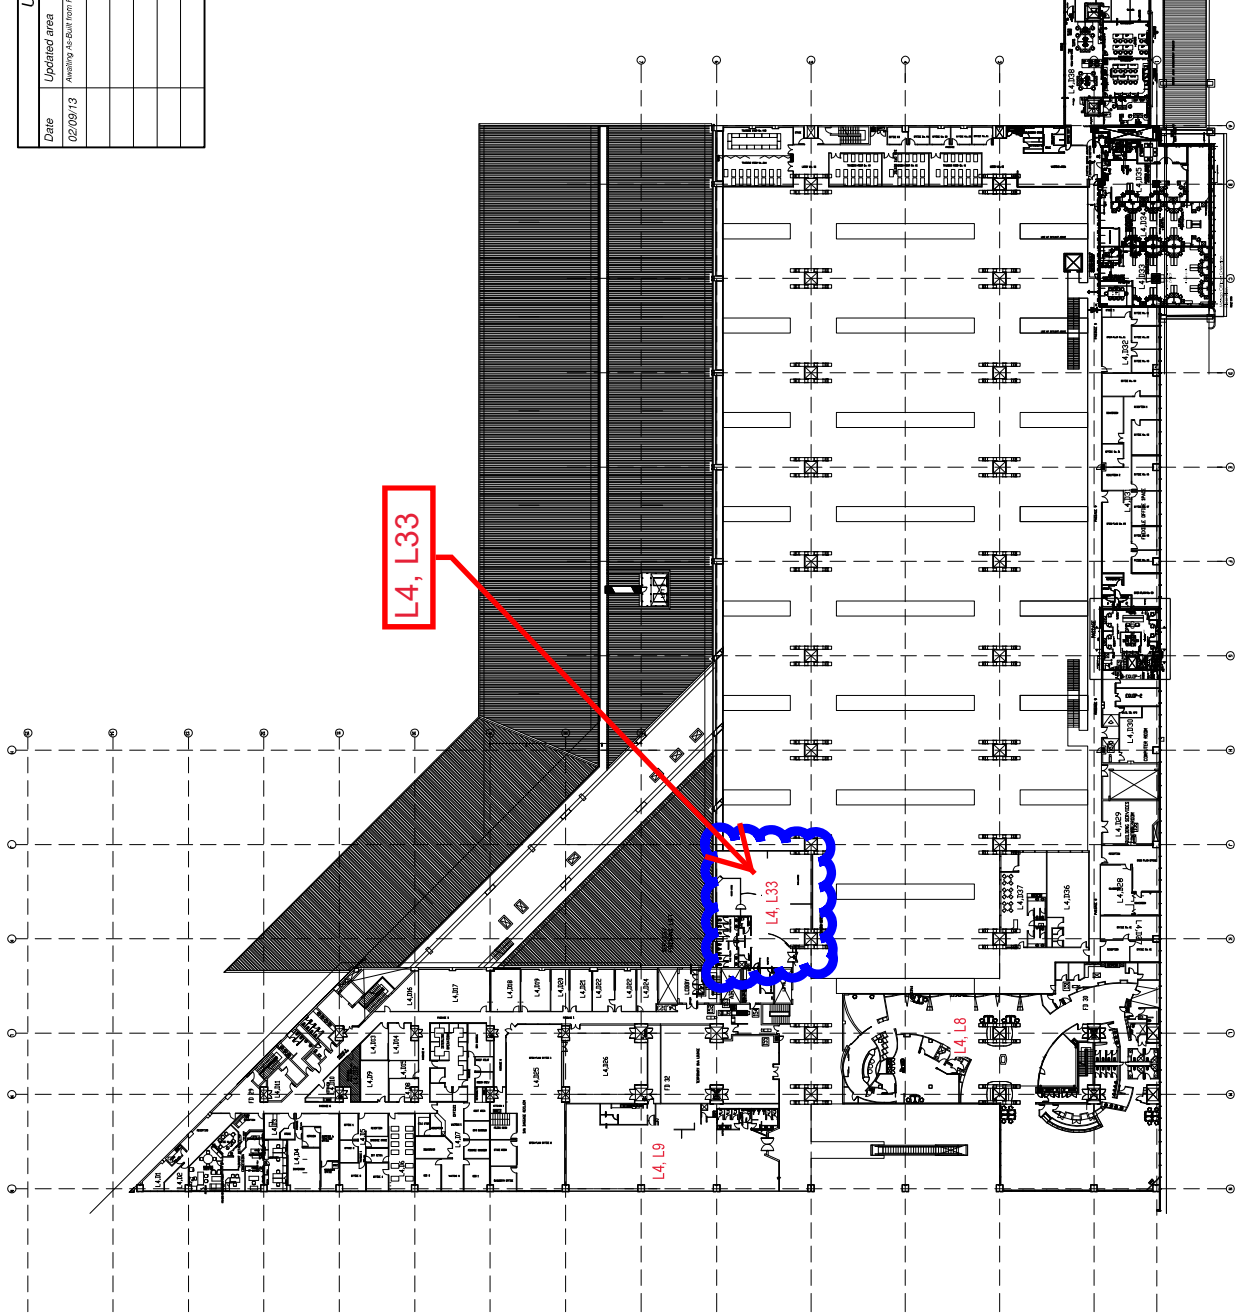

PROJECT MANAGEMENT DIVISION  
 Drawing by : Zacharia  
 921 6362

Scale : NTS  
 Date : JUNE 2008  
 Checked by : Skhumbuzo

DOMTEX - OFFICES LEVEL  
 O.R. TAMBO INTERNATIONAL AIRPORT

drawing no.  
**6-005**